

DO NOT SCALE FROM THIS DRAWING, USE FIGURED DIMENSIONS ONLY.

ALL DIMENSIONS TO BE CHECKED ON SITE PRIOR TO ANY COMMENCEMENT OF WORK AND ANY OMISSIONS/ERRORS TO BE REPORTED TO THE ARCHITECT.

THIS DRAWING IS TO READ IN CONJUNCTION WITH ALL RELATED ARCHITECT'S AND ENGINEERS DRAWINGS AND ANY OTHER RELEVANT INFORMATION.

THE COPYRIGHT OF THIS DRAWING IS VESTED WITH HARRIS IRWIN ASSOCIATES AND MUST NOT BE COPIED OR REPRODUCED WITHOUT THEIR WRITTEN CONSENT.

**AMENDED**

25/05/17

Rev	Date	Comment	By
A	25.05.17	Red line boundary updated	JMC



ASKE STABLES, NORTH YORKSHIRE  
 ASKE, DL10 5HG  
 RICHMOND

t: 01748 825675  
 e: enquiries@harrisirwin.com  
 w: www.harrisirwin.com



**Project:**  
 14 Hill Close  
 Reeth  
 DL11 6RX


**Client:**  
 Mr & Mrs S Morgan

**Drawing:**  
 Site Location Plan

Scale @ A4	Date:	Drawn:	Checked:
1:1250	11.10.16		

Proj. No.:	Status:	Dwg. No.:	Rev No.:
2136	S.	10.	A

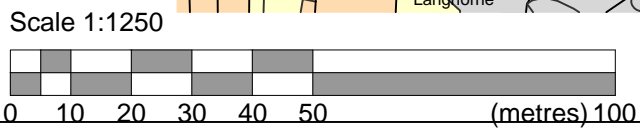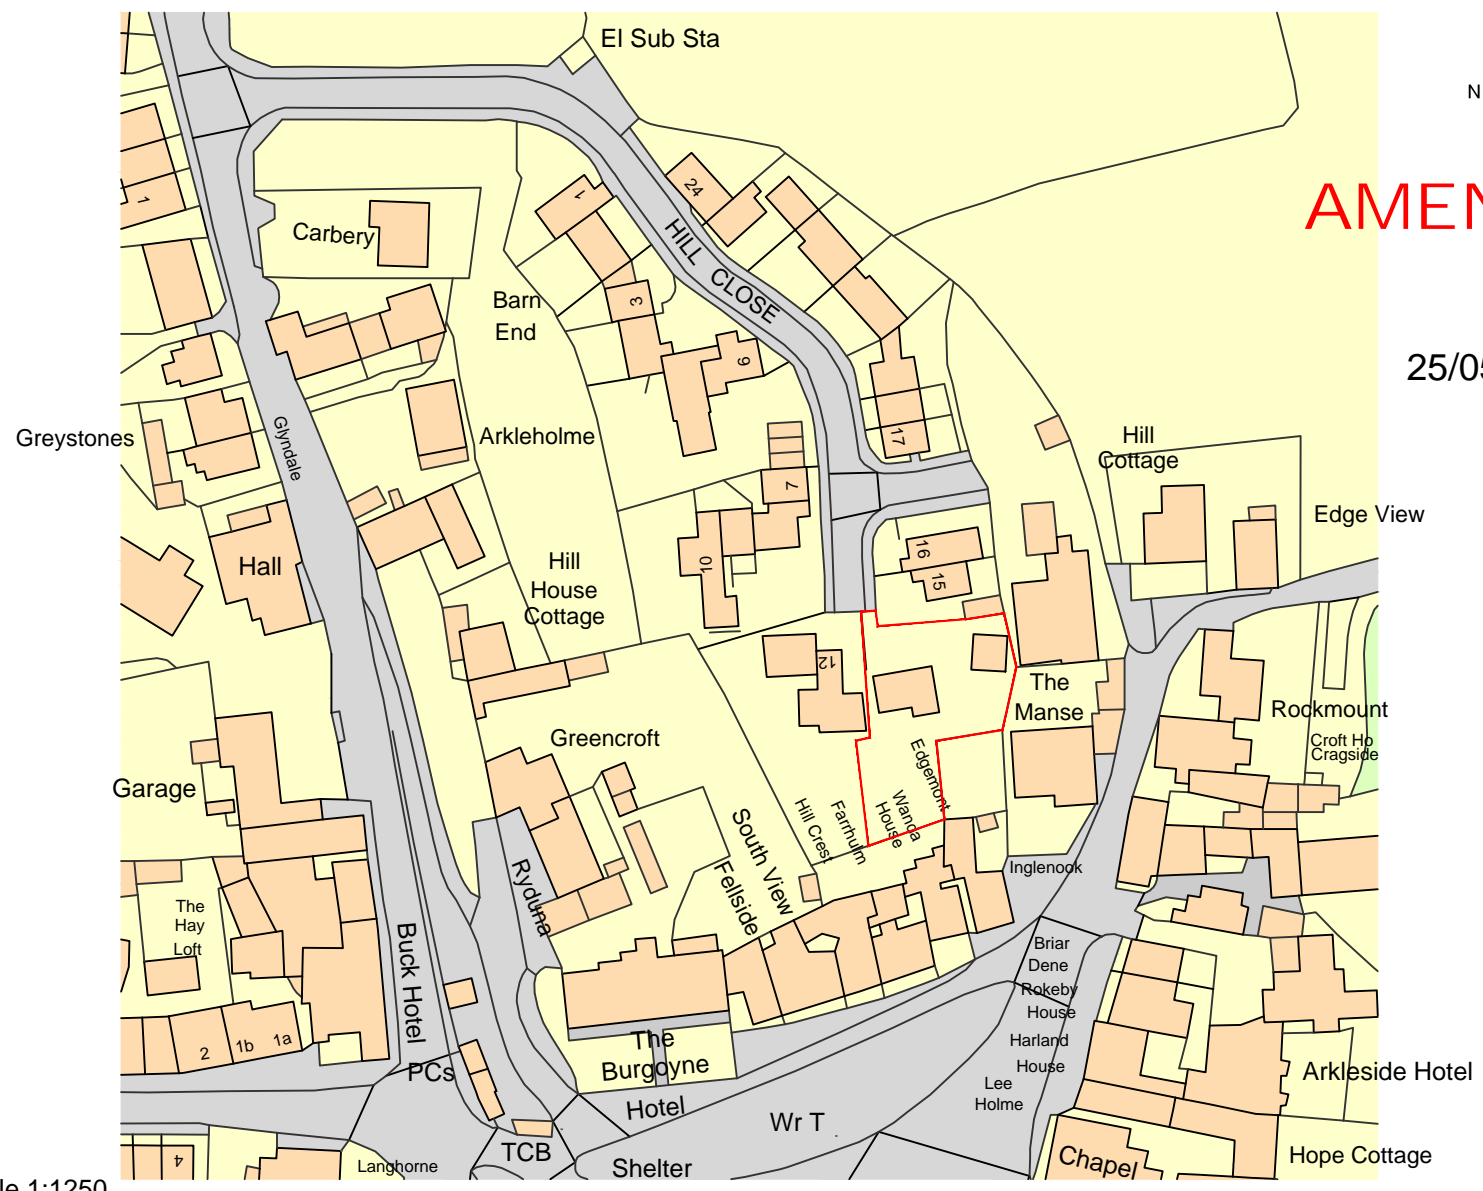

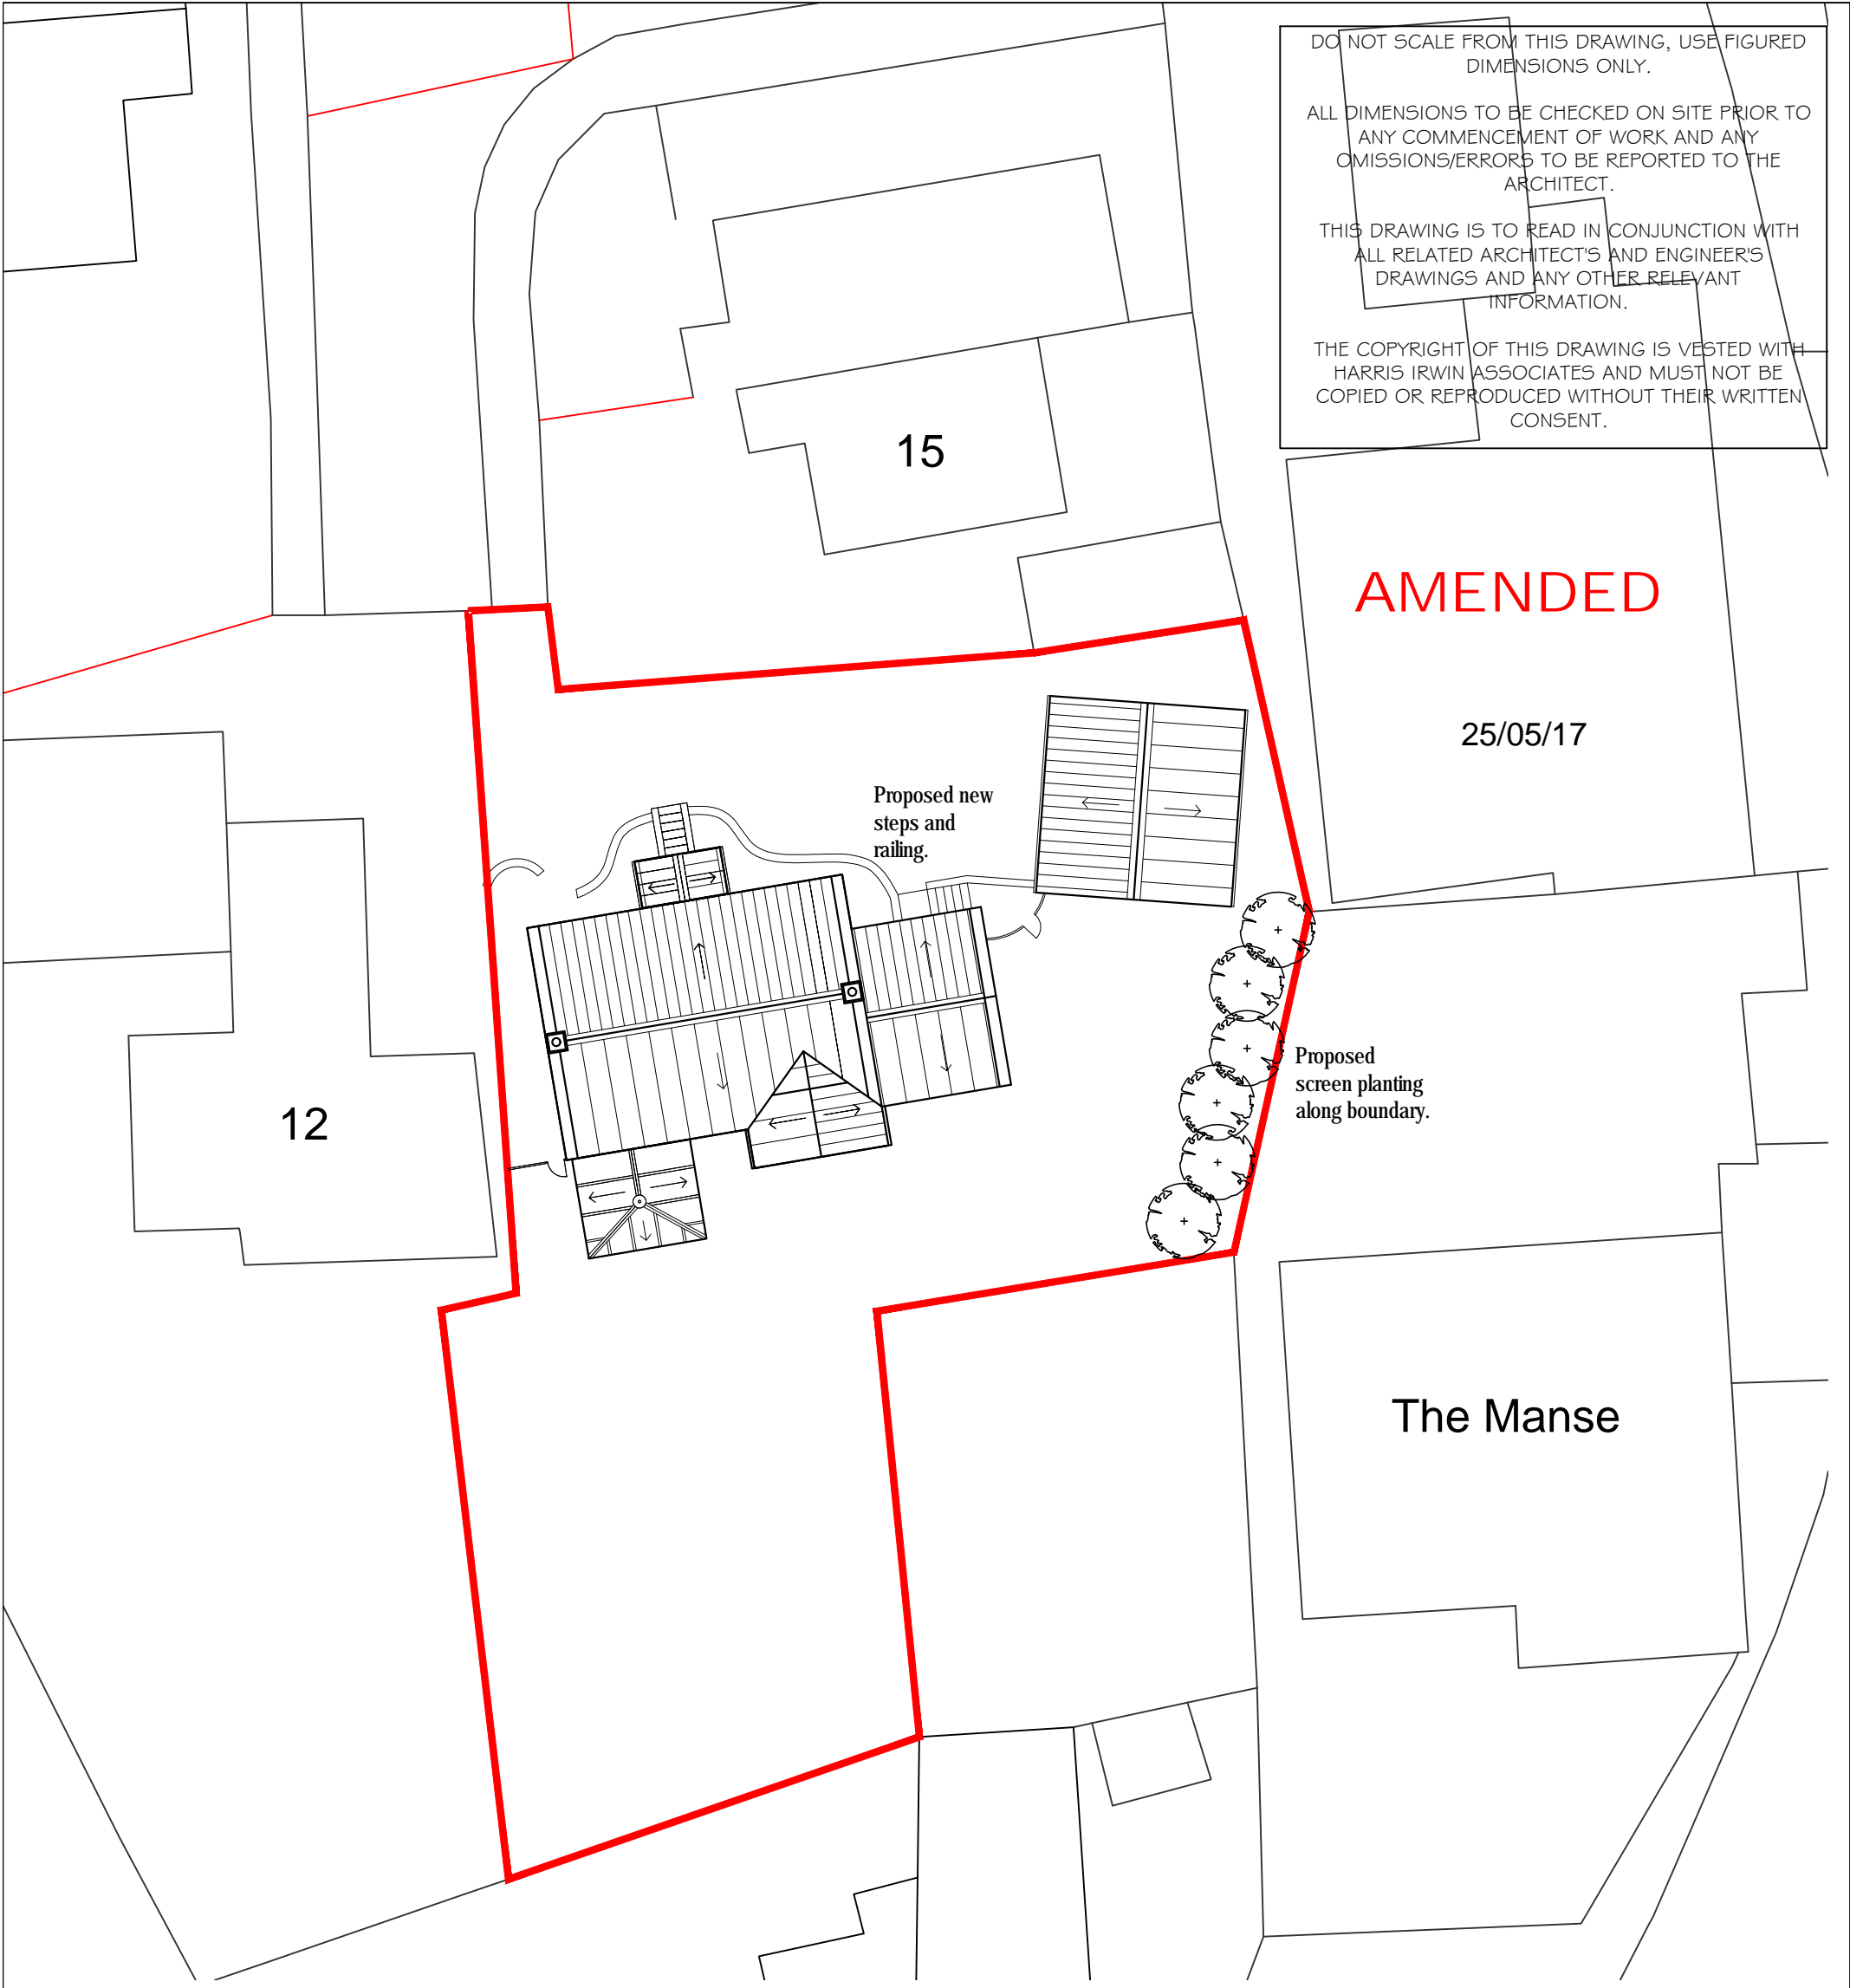

DO NOT SCALE FROM THIS DRAWING, USE FIGURED DIMENSIONS ONLY.

ALL DIMENSIONS TO BE CHECKED ON SITE PRIOR TO ANY COMMENCEMENT OF WORK AND ANY OMISSIONS/ERRORS TO BE REPORTED TO THE ARCHITECT.

THIS DRAWING IS TO READ IN CONJUNCTION WITH ALL RELATED ARCHITECT'S AND ENGINEER'S DRAWINGS AND ANY OTHER RELEVANT INFORMATION.

THE COPYRIGHT OF THIS DRAWING IS VESTED WITH HARRIS IRWIN ASSOCIATES AND MUST NOT BE COPIED OR REPRODUCED WITHOUT THEIR WRITTEN CONSENT.

**AMENDED**

25/05/17

Proposed new steps and railing.

Proposed screen planting along boundary.

The Manse

12

15

A	25.05.17	Red line boundary updated.	JMC
Rev	Date	Comment	By

**Drawing:**  
Proposed Site Plan

**PLANNING**

Scale @ A3	Date:	Drawn:	Checked:
1:200	Dec' 16	RDA	TO

Proj. No.:	Status:	Dwg. No.:	Rev No.:
2136	PL	003	A


**harrisirwin**  
architects & designers

ASKE STABLES, ASKE, RICHMOND  
NORTH YORKSHIRE DL10 5HG

t: 01748 825675  
e: enquiries@harrisirwin.com  
w: www.harrisirwin.com

**Project:**  
Alterations and Extension to  
14 Hill Close,  
Reeth

**Client:**  
Mr & Mrs S. Morgan

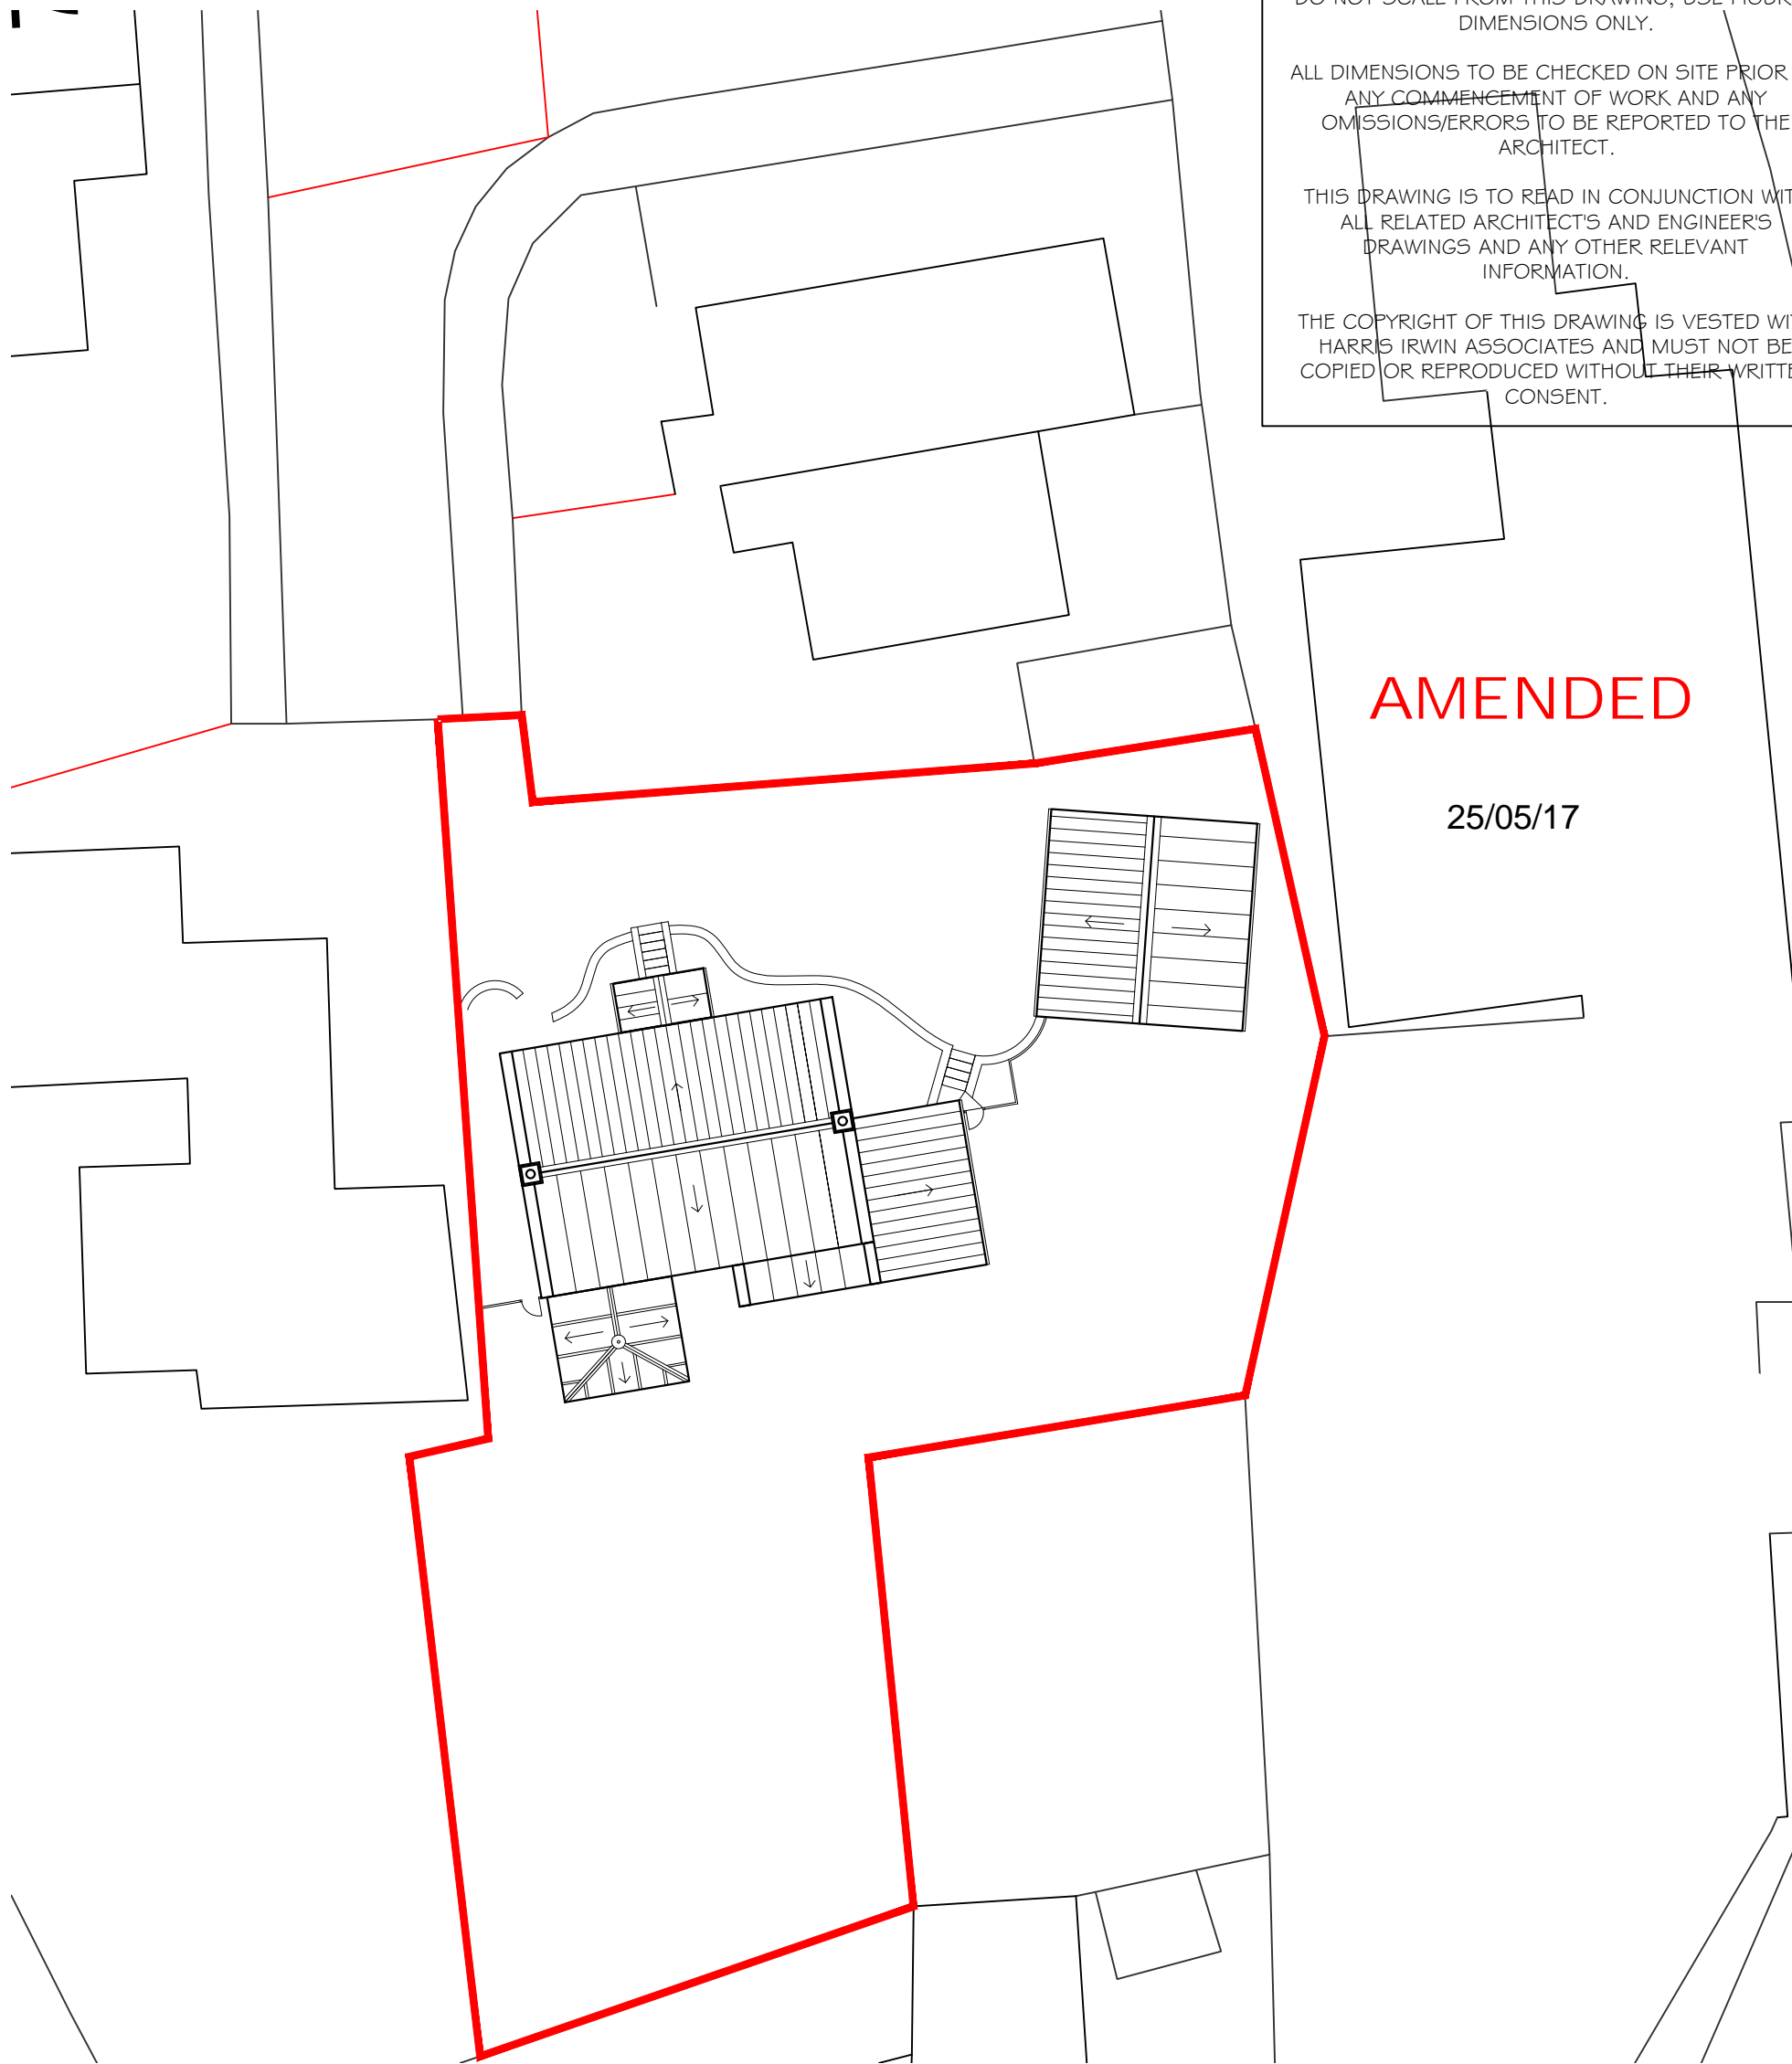

DO NOT SCALE FROM THIS DRAWING, USE FIGURED DIMENSIONS ONLY.

ALL DIMENSIONS TO BE CHECKED ON SITE PRIOR TO ANY COMMENCEMENT OF WORK AND ANY OMISSIONS/ERRORS TO BE REPORTED TO THE ARCHITECT.

THIS DRAWING IS TO READ IN CONJUNCTION WITH ALL RELATED ARCHITECT'S AND ENGINEER'S DRAWINGS AND ANY OTHER RELEVANT INFORMATION.

THE COPYRIGHT OF THIS DRAWING IS VESTED WITH HARRIS IRWIN ASSOCIATES AND MUST NOT BE COPIED OR REPRODUCED WITHOUT THEIR WRITTEN CONSENT.

**AMENDED**

25/05/17

A	25.05.17	Red line boundary updated	JMC
Rev	Date	Comment	By

**Drawing:**  
Existing Site Plan

**PLANNING**

<b>Scale @ A3</b>	<b>Date:</b>	<b>Drawn:</b>	<b>Checked:</b>
1:200	Dec' 16	RDA	TO

<b>Proj. No.:</b>	<b>Status:</b>	<b>Dwg. No.:</b>	<b>Rev No.:</b>
2136	S	003	A



ASKE STABLES, ASKE, RICHMOND  
NORTH YORKSHIRE DL10 5HG

t: 01748 825675  
e: enquiries@harrisirwin.com  
w: www.harrisirwin.com

**Project:**  
Proposed alterations and Extension to  
14 Hill Close,  
Reeth

**Client:**  
Mr & Mrs S. Morgan



# AMENDED

25/05/17

DO NOT SCALE FROM THIS DRAWING. USE FIGURED DIMENSIONS ONLY.

ALL DIMENSIONS TO BE CHECKED ON SITE PRIOR TO ANY COMMENCEMENT OF WORK AND ANY OMISSIONS/ERRORS TO BE REPORTED TO THE ARCHITECT.

THIS DRAWING IS TO READ IN CONJUNCTION WITH ALL RELATED ARCHITECTS AND ENGINEERS DRAWINGS AND ANY OTHER RELEVANT INFORMATION.

THE COPYRIGHT OF THIS DRAWING IS VESTED WITH HARRIS IRWIN ASSOCIATES AND MUST NOT BE COPIED OR REPRODUCED WITHOUT THEIR WRITTEN CONSENT.



Proposed North Elevation  
Scale 1:100



Proposed East Elevation  
Scale 1:100

Fixed window with obscured glazing.



Proposed South Elevation  
Scale 1:100



Proposed West Elevation  
Scale 1:100

Rev	Date	Comment	By
C	25.05.17	Drawing revised following comments from planners.	AKC
B	29.04.17	Drawing revised following comments from planners.	AKC
A	16.12.16	Conservatory door added to east elevation.	EDA

**harrisirwin**  
architects & designers

ASKE STABLES,  
NORTH YORKSHIRE

ASKE, RICHMOND  
DL10 5HG

t : 01748 825675  
e : enquiries@harrisirwin.com  
w : www.harrisirwin.com

**Project:**  
Proposed Alterations and Extension to  
14 Hill Close, REETH,  
North Yorks. DL11 6RX


**Client:**  
Mr & Mrs S. Morgan

**Drawing:**  
Proposed Elevations

## PLANNING

Scale @ A3	Date	Drawn	Checked
1:100	Dec' 16	RDA	TO

Proj. No.:	Status:	Dwg. No.:	Rev No.:
2136	PL	002	C

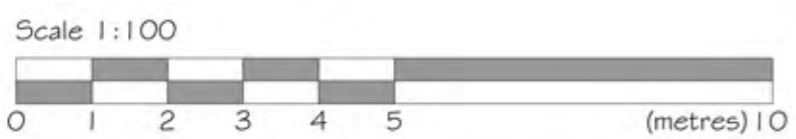

# AMENDED





25/05/17

DO NOT SCALE FROM THIS DRAWING, USE FIGURED DIMENSIONS ONLY.

ALL DIMENSIONS TO BE CHECKED ON SITE PRIOR TO ANY COMMENCEMENT OF WORK AND ANY OMISSIONS/ERRORS TO BE REPORTED TO THE ARCHITECT.

THIS DRAWING IS TO READ IN CONJUNCTION WITH ALL RELATED ARCHITECT'S AND ENGINEER'S DRAWINGS AND ANY OTHER RELEVANT INFORMATION.

THE COPYRIGHT OF THIS DRAWING IS VESTED WITH HARRIS IRWIN ASSOCIATES AND MUST NOT BE COPIED OR REPRODUCED WITHOUT THEIR WRITTEN CONSENT.

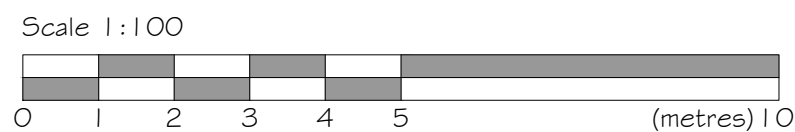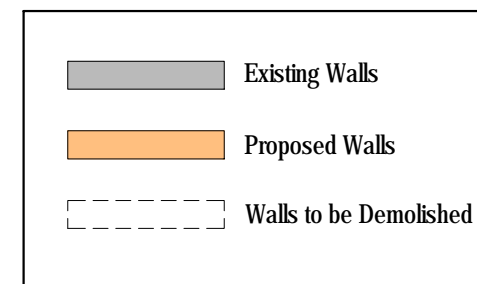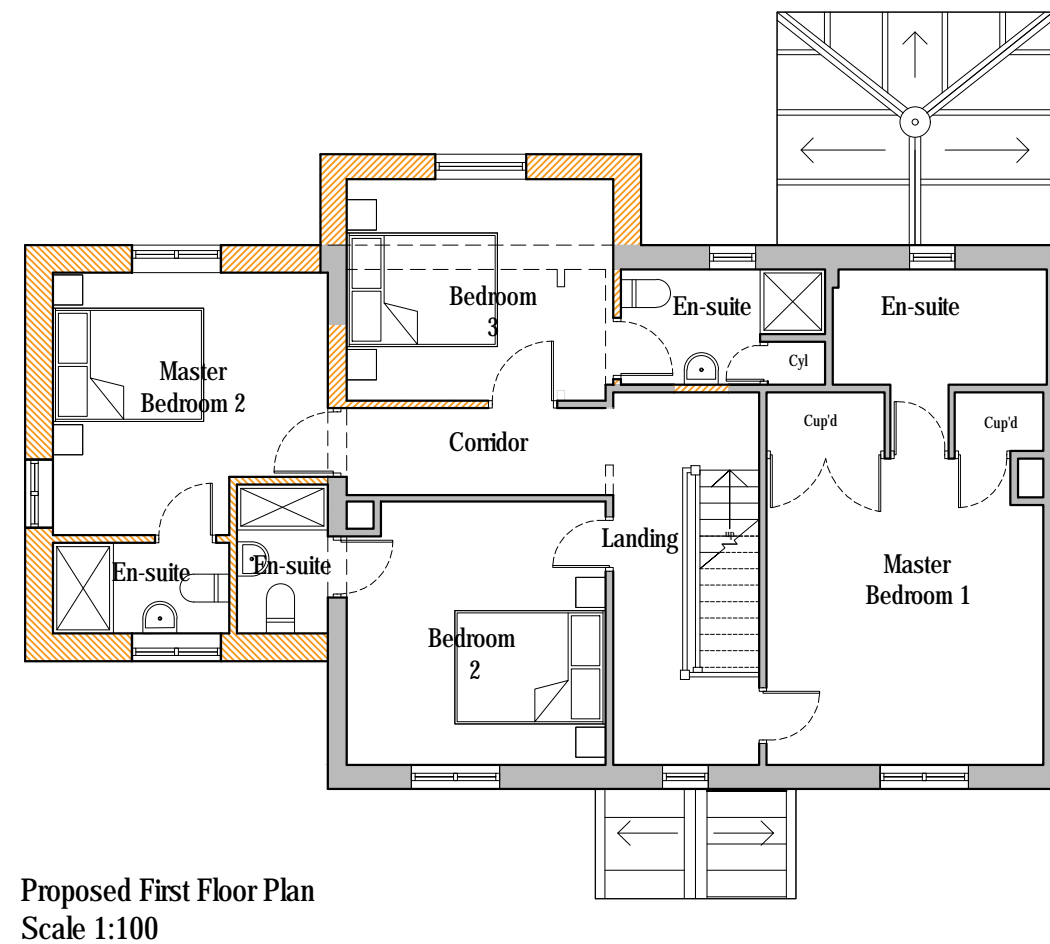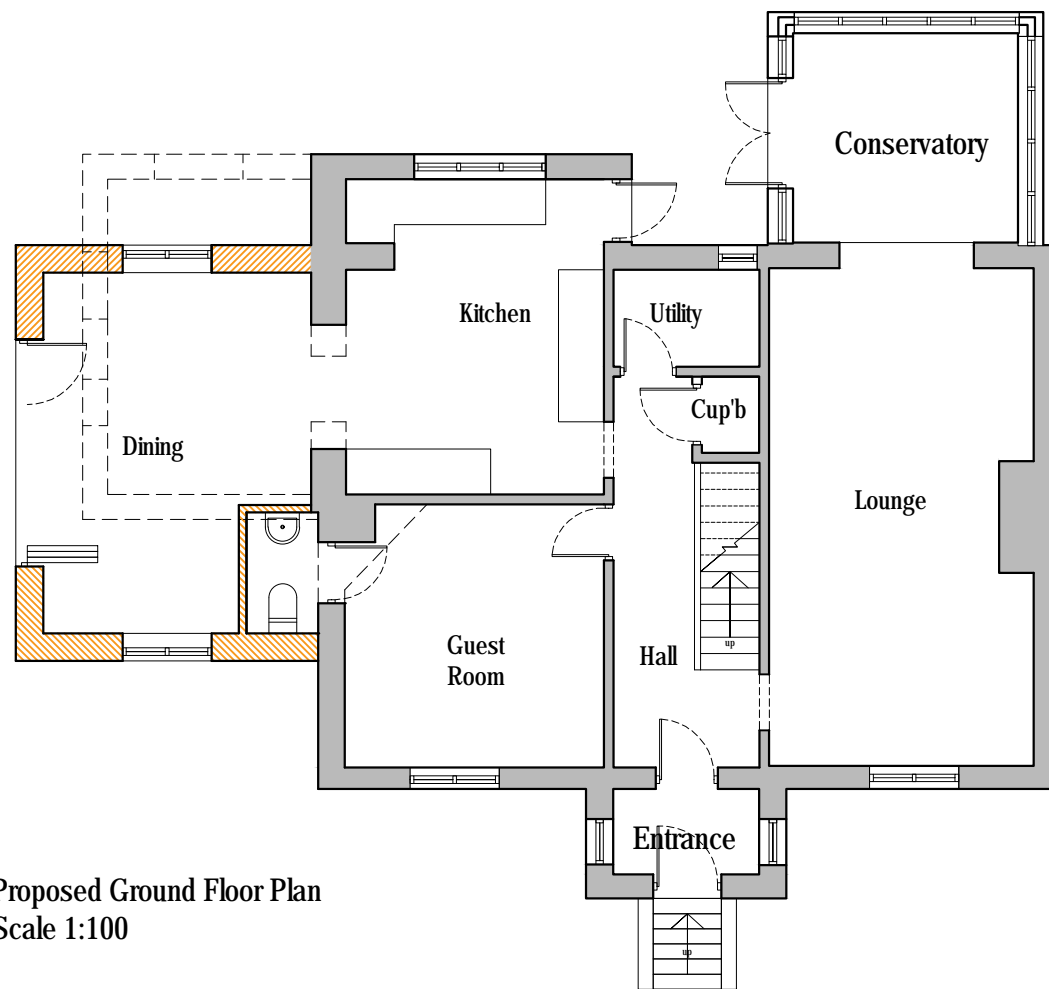

Rev	Date	Comment	By
A	07.04.17	Drawing revised following comments from planners.	JMC

**harrisirwin**  
architects & designers

ASKE STABLES, NORTH YORKSHIRE  
ASKE, RICHMOND DL10 5HG  
t : 01748 825675  
e : enquiries@harrisirwin.com  
w : www.harrisirwin.com

**Project:**  
Proposed Alterations and Extension to 14 Hill Close, Reeth

**Client:**  
Mr & Mrs S. Morgan

**Drawing:**  
Proposed Floor Plans

**PLANNING**

Scale @ A3	Date:	Drawn:	Checked:
1:100	Dec' 16	RDA	TO

Proj. No.:	Status:	Dwg. No.:	Rev No.:
2136	PL	001	A