

Ordnance Survey, (c) Crown Copyright 2014. All rights reserved. Licence number 100022432

NOTES:

DO NOT SCALE FROM THIS DRAWING.

1. This drawing is copyright of WardmanBrown. WardmanBrown is a trading name of Wardmans Architectural Services Limited.
2. All dimensions to be verified on site prior to any shop or site works being commenced.
3. Any discrepancies to be reported to the Designer BEFORE any work is put in hand.
4. This drawing must be read in conjunction with relevant consultants and specialists drawings.
5. This drawing must be read in conjunction with the drawings specified.

CDM 2015 - ( Refer to Project Health & Safety Information )

HAZARDS


1. Live services adjacent/on site.
2. Excavations - Ground Collapse
3. Handling major components
4. Working at height - Falling
5. Machinery & Equipment
6. Ensure all blockwork has a minimum crushing strength of 3.5N/mm<sup>2</sup>
7. The weight of each block must not exceed 20Kg



| REV | DATE | DETAILS |
|-----|------|---------|
|     |      |         |
|     |      |         |
REVISIONS:


|  |
|--|
| CLIENT:<br>Mrs Tansley   |
| PROJECT:<br>BIOMASS BUILDING AND CAR PORT<br>Scale House, Rybstone, Skipton BD23 6ER |
| DRAWING TITLE:<br>Location Plan  |
| PURPOSE OF ISSUE:<br><b>PLANNING DRAWING</b>   |
| SCALE: 1:500 @ A3  |
| DATE: OCT 2015   DRAWN:LSW   DRG REVISION:   |
| DRAWING NO: <b>L015037 - 003</b>   -   |

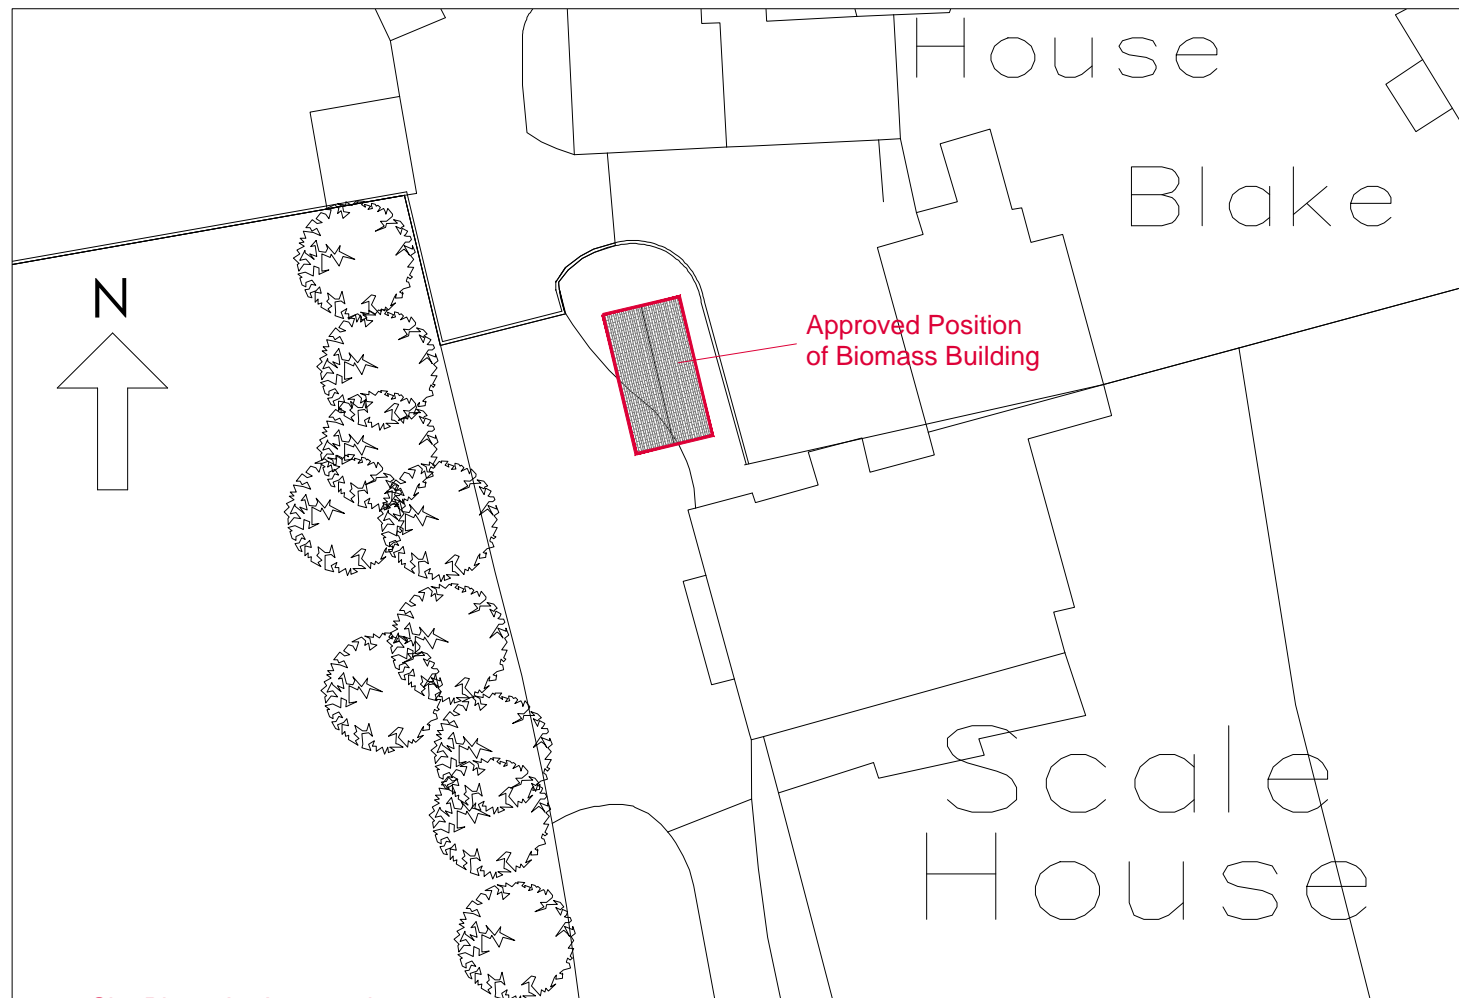

Site Plan - As Approved 1:500

- NOTES:
- DO NOT SCALE FROM THIS DRAWING.
1. This drawing is copyright of WardmanBrown. WardmanBrown is a trading name of Wardmans Architectural Services Limited.
  2. All dimensions to be verified on site prior to any shop or site works being commenced.
  3. Any discrepancies to be reported to the Designer BEFORE any work is put in hand.
  4. This drawing must be read in conjunction with relevant consultants and specialists drawings.
  5. This drawing must be read in conjunction with the drawings specified.

- CDM 2015 - ( Refer to Project Health & Safety Information )
- HAZARDS
1. Live services adjacent/on site.
  2. Excavations - Ground Collapse
  3. Handling major components
  4. Working at height - Falling
  5. Machinery & Equipment
  6. Ensure all blockwork has a minimum crushing strength of 3.5N/mm<sup>2</sup>
  7. The weight of each block must not exceed 20Kg

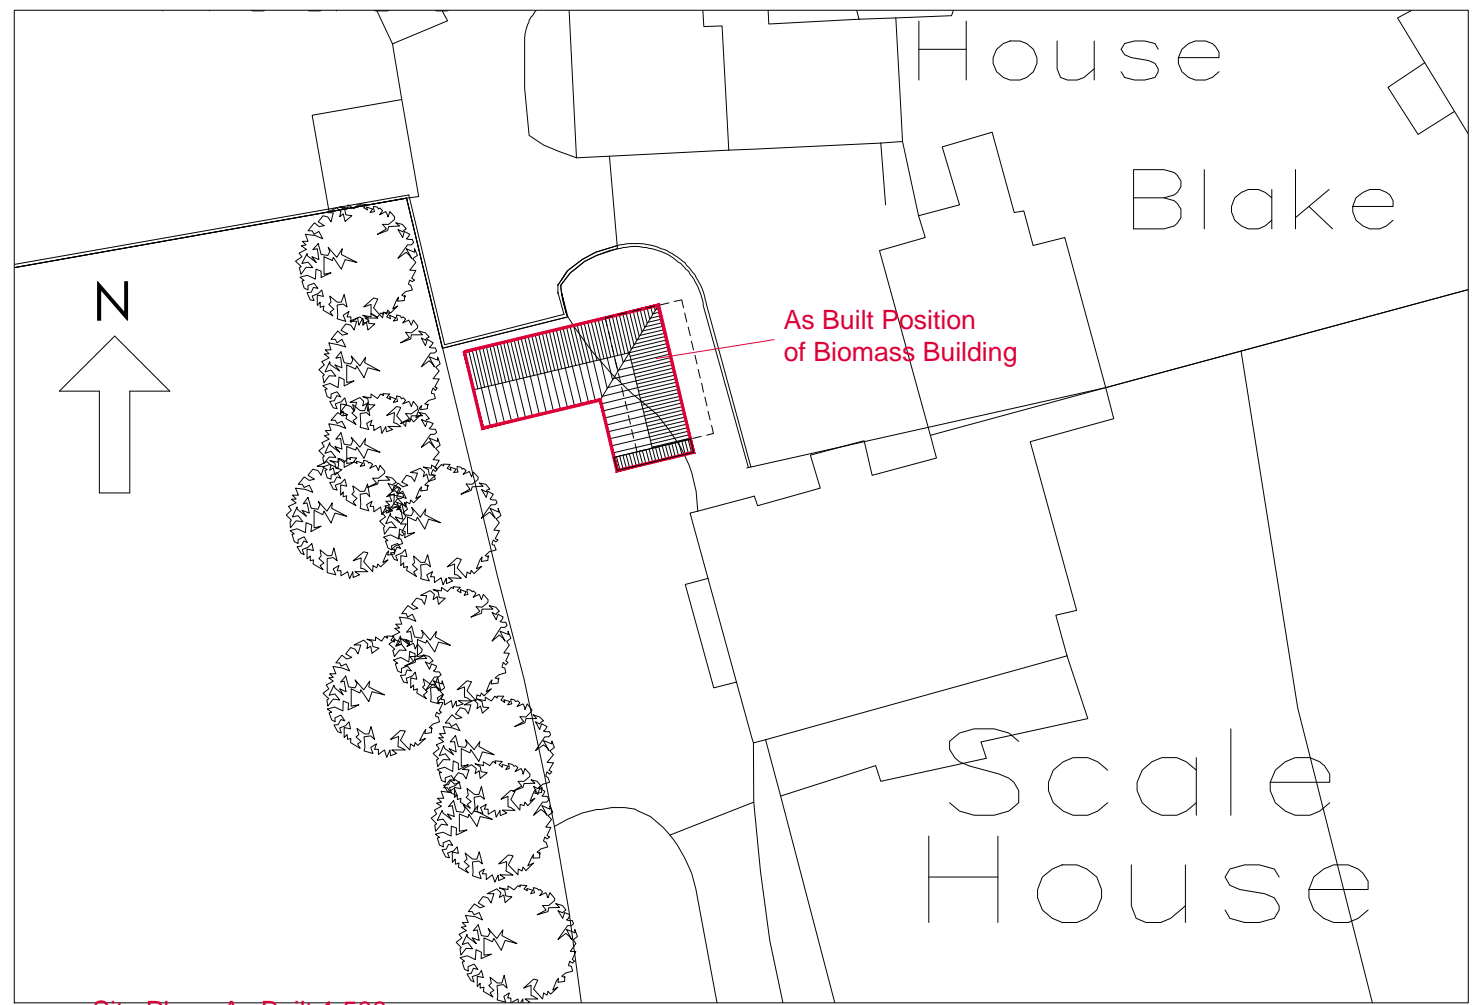

Site Plan - As Built 1:500


| REV | DATE | DETAILS |
|-----|------|---------|
|     |      |         |
|     |      |         |
|     |      |         |
|     |      |         |

REVISIONS:


**Wardman Brown**

Hilarnie, Bellerby, Leyburn  
 North Yorkshire DL8 5QP  
 Tel: 01969 600251  
 info@wardmanbrown.com  
 www.wardmanbrown.com


|  |
|--|
| CLIENT:<br>Mrs Tansey  |
| PROJECT:<br>BIOMASS BUILDING AND CAR PORT<br>Scale House, Rytstone, Skipton BD23 6ER |
| DRAWING TITLE:<br>As Built Site Plan   |
| PURPOSE OF ISSUE:<br><b>PLANNING DRAWING</b>   |
| SCALE: 1:500 @ A3  |
| DATE: OCT 2015   DRAWN:LSW   DRG REVISION:   |
| DRAWING NO: L015037 - 002  |

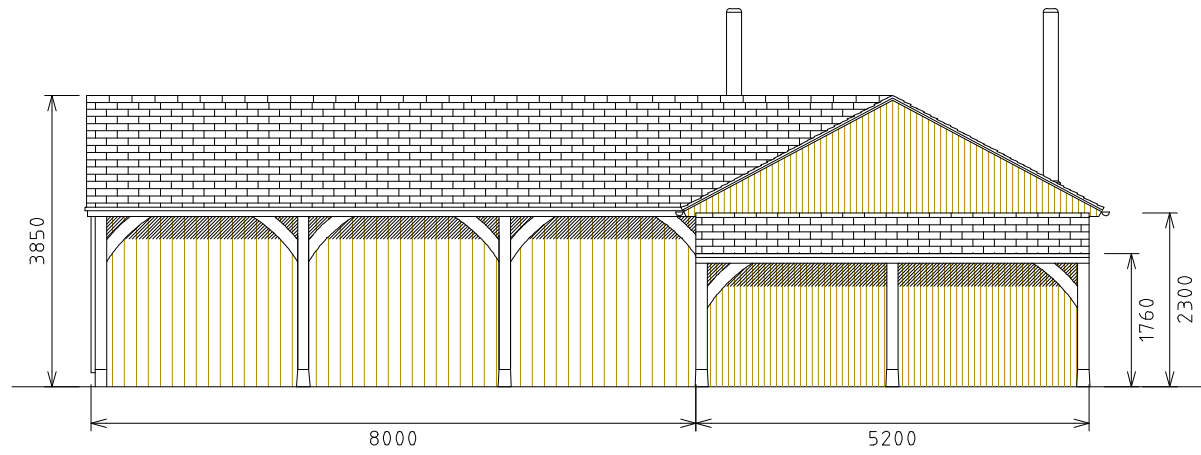


South Elevation

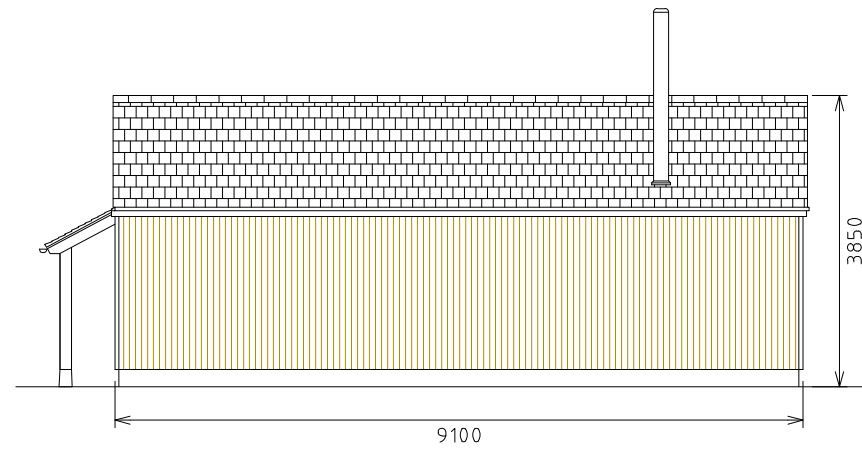

East Elevation

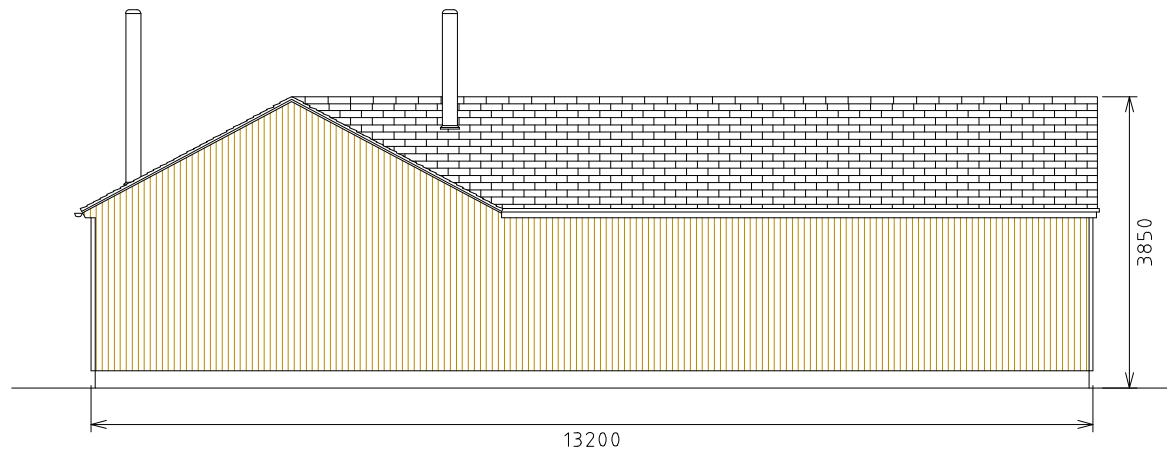

North Elevation

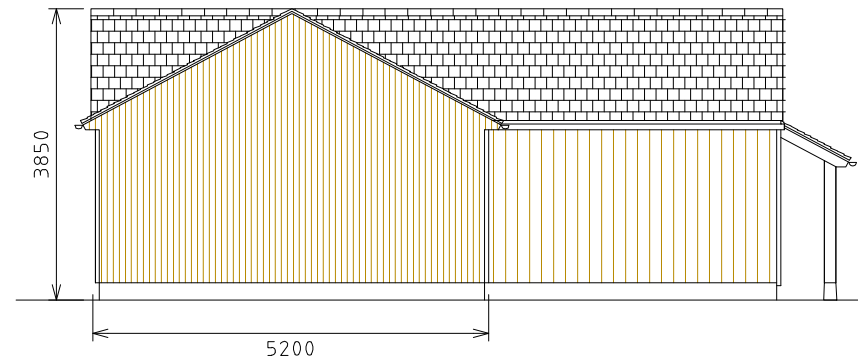

West Elevation

NOTES:

- DO NOT SCALE FROM THIS DRAWING.
1. This drawing is copyright of WardmanBrown. WardmanBrown is a trading name of Wardmans Architectural Services Limited.
  2. All dimensions to be verified on site prior to any shop or site works being commenced.
  3. Any discrepancies to be reported to the Designer BEFORE any work is put in hand.
  4. This drawing must be read in conjunction with relevant consultants and specialists drawings.
  5. This drawing must be read in conjunction with the drawings specified.

CDM 2015 - ( Refer to Project Health & Safety Information )

HAZARDS

1. Live services adjacent/on site.
2. Excavations - Ground Collapse
3. Handling major components
4. Working at height - Falling
5. Machinery & Equipment
6. Ensure all blockwork has a minimum crushing strength of 3.5N/mm<sup>2</sup>
7. The weight of each block must not exceed 20Kg



| REV | DATE | DETAILS |
|-----|------|---------|
|     |      |         |
|     |      |         |
REVISIONS:



South View



East View



North View

**Wardman Brown**

Hilamie, Bellerby, Leyburn  
North Yorkshire DL8 5QP  
Tel: 01969 600251  
info@wardmanbrown.com  
www.wardmanbrown.com

|  |            |               |
|--|------------|---------------|
| CLIENT:<br>Mrs Tansey  |            |               |
| PROJECT:<br>BIOMASS BUILDING AND CAR PORT<br>Scale House, Rylstone, Skipton BD23 6ER |            |               |
| DRAWING TITLE:<br>As Built Elevations  |            |               |
| PURPOSE OF ISSUE:<br><b>PLANNING DRAWING</b>   |            |               |
| SCALE: 1:100 @ A3  |            |               |
| DATE: OCT 2015   | DRAWN: LSW | DRG REVISION: |
| DRAWING NO: L015037 - 001  |            | -             |